8383

WILSHIRE

SUITE 212 | 1,987 RSF

BEVERLY HILLS

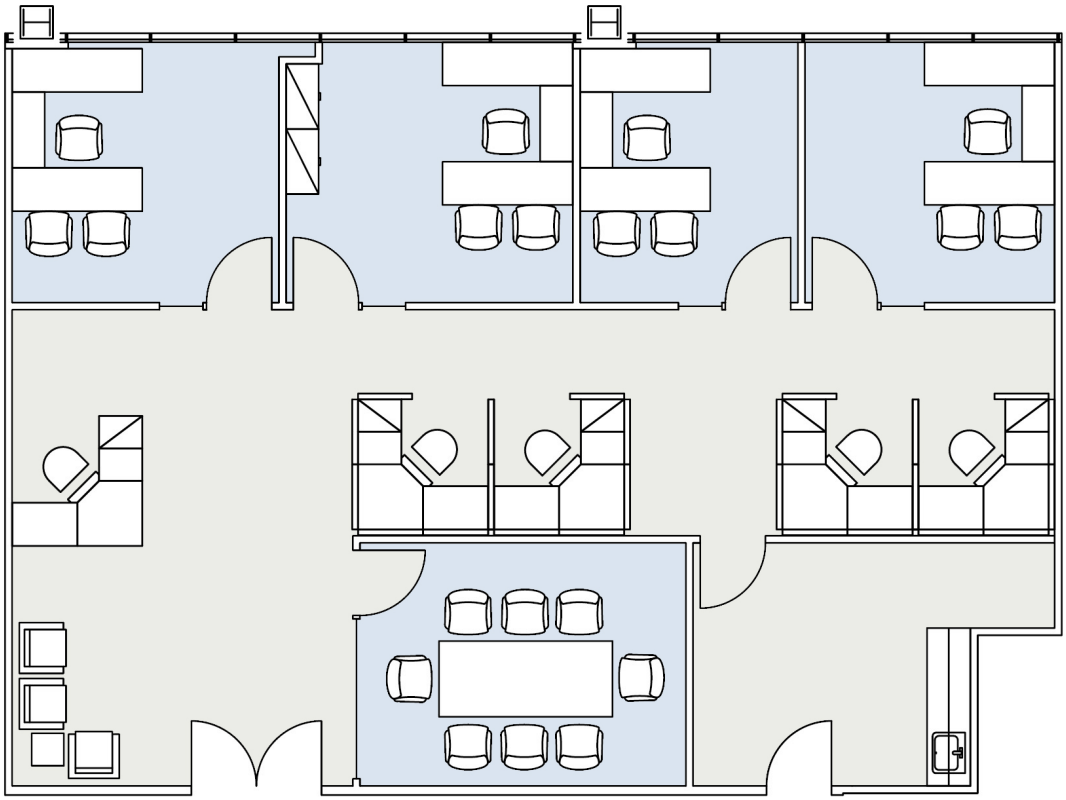

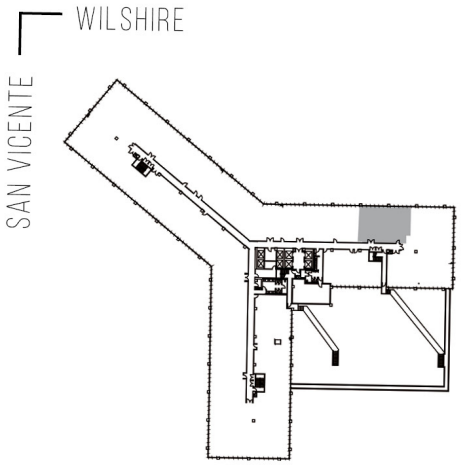

AS-BUILT CONFIGURATION

OFFICES:	4
CONFERENCE ROOM:	1
RECEPTION:	1
KITCHEN:	1

NOT TO SCALE
FURNITURE NOT INCLUDED

For more information, please contact:

MELINDA MECHOSO
310.255.7737
mmechoso@douglasemmett.com

CARLTON MAESE
310.255.7781
cmaese@douglasemmett.com

EDMUND HA
310.255.7743
edmund.ha@douglasemmett.com

Douglas Emmett